



over 6" Dense  
Graded Subbase

- 1 The maximum algebraic difference in grades shall not exceed 8% for crest vertical curves, nor 12% for sag vertical curves.

② See Standard Drawing E 610-DRIV-16 for longitudinal joint details.

③ Ear construction type B ~~as shown~~ as shown on Standard Drawing E605-BECN-02

**W = Width of sidewalk**

Y = Distance from front face of curb  
to R or R/W

	Curb ramp
--	-----------

 Curb ramp view

Concrete pavement



1167

INDIANA DEPARTMENT OF TRANSPORTATION

### CLASS I DRIVE

## SIDEWALK ADJACENT TO CURB


JANUARY 2000

STANDARD DRAWING NO. E 610-DRIV-01

/s/ Anthony L. Krenovich 7-03-00  
DESIGN STANDARD ENGINEER DATE

24

*W. Firez Zandi* 1-03-00  
CHIEF HIGHWAY ENGINEER DATE

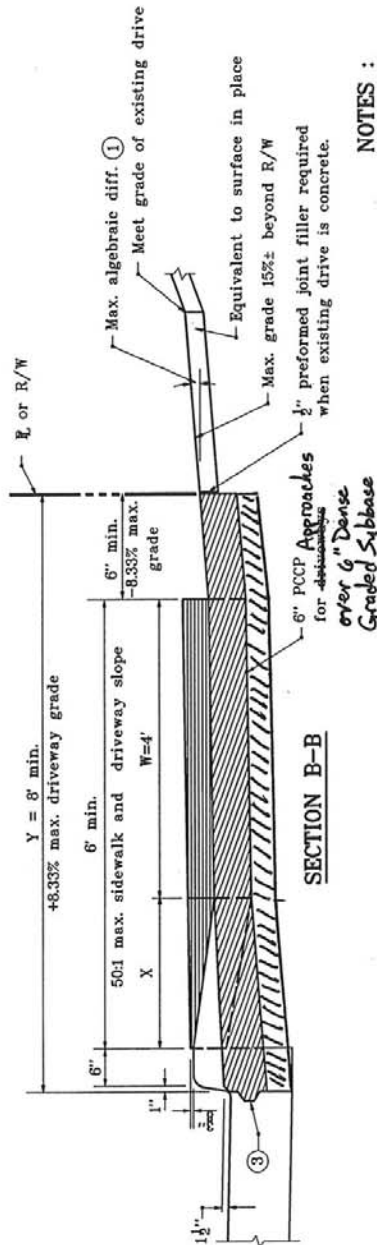


SECTION B-B

NOTES :

- ① The maximum algebraic difference in grades shall not exceed 8% for crest vertical curves, nor 12% for sag vertical curves.
- ② The limits for X are based on a 6" curb height. For other curb heights, the limits for X shall be adjusted.
- ③ See Standard Drawing E 610-DRIV-16 for joint details.
- ④ See Standard Drawing E 610-DRIV-16 for joint details.

**LEGEND**  
 W = Width of sidewalk  
 X = Distance between back face of curb and sidewalk  
 Y = Distance from front face of curb to R/W or R/W

▬ Curb ramp  
 ▬ Curb ramp view.

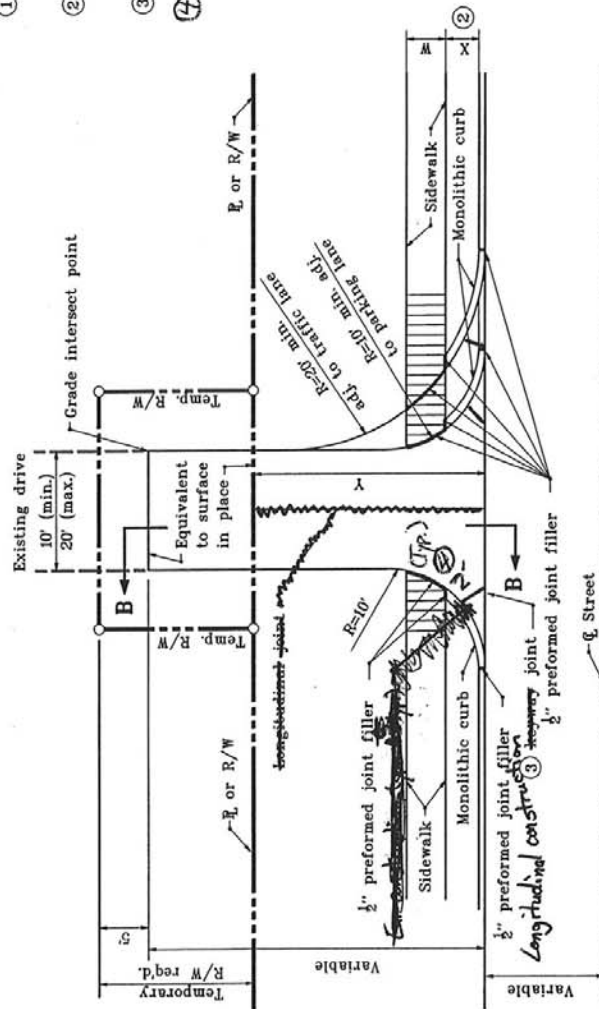

PLAN VIEW

X = 2' TO LESS THAN 6' FROM FACE OF CURB

INDIANA DEPARTMENT OF TRANSPORTATION	
CLASS I DRIVE	
SIDEWALK NOT ADJACENT TO CURB	
JANUARY 2000	
STANDARD DRAWING NO.E 610-DRIV-02	
	DATE 1-03-00 1-03-00



## SECTION C-C



X = 6' AND OVER FROM FACE OF CURB

- NOTES :**

① The maximum algebraic difference in grades shall not exceed 8% for crest vertical curves, nor 12% for sag vertical curves.

② The limits for X are based on a 6" curb height. For other curb heights, the limits for X shall be adjusted.

③ See Standard Drawing E 610-DRIV-16 for ~~heavy~~ construction joint details.

④ longitudinal  
Ear construction type B ~~with~~ as shown  
LEGEND on Standard Drawing E-1005-16  
W = Width of sidewalk


= Width of sidewalk

$X$  = Distance between back face of curb and sidewalk

Y = Distance from front face of curb to  
P or R/W


Existing Drive Surface  
Aggregate  
Asphalt

⑤ 6" Compacted Aggregate Surface, No. 73  
(M) on (P)

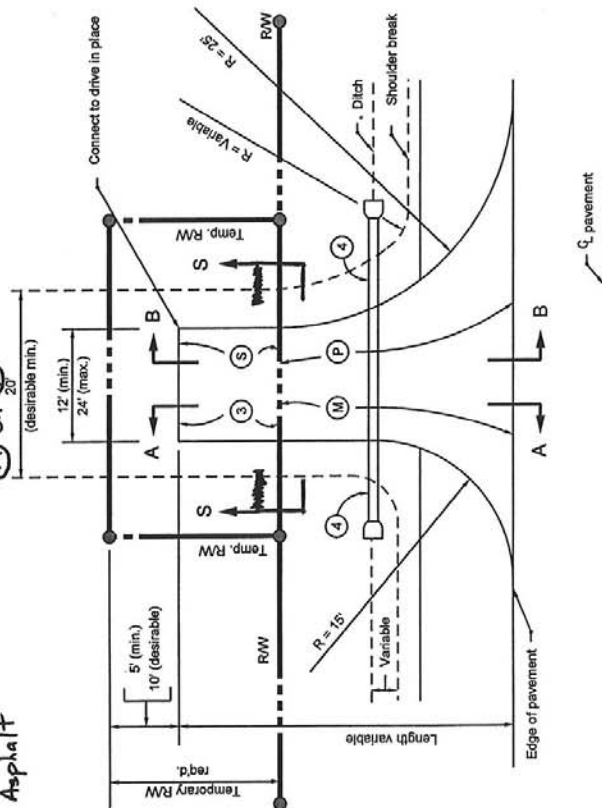

# PLAN VIEW

USED FOR RESIDENCES, BARN, PRIVATE GARAGES, ETC.

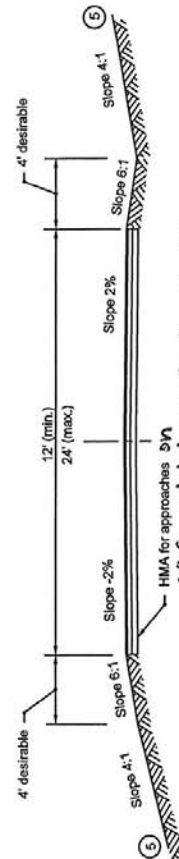

⑤ 8" Compacted Aggregate Base, No. 53


# SECTION S-S

## NOTES:

- The driveway detailed on this sheet shall be used under the following conditions:
  - the mainline shoulder is paved and is less than 8 ft in width
  - the mainline shoulder is not paved
  - the existing drive surface is asphalt or aggregate
- If the driveway surface is unimproved cross section as for driveway Class V can be used in place of Section S-S, see Drawing E 610-DRIV-11 for details.
- See Standard Drawing E 610-DRIV-07 for General Notes.
- See Standard Drawing E 610-DRIV-06 for Sections A-A and B-B.

## LEGEND

- (M) Limits of HMA for approaches
- (P) Limits of compacted aggregate base
- (S) Equivalent to surface in place - See above

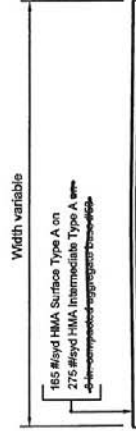

## HMA FOR APPROACHES TYPICAL SECTION

INDIANA DEPARTMENT OF TRANSPORTATION	
CLASS II DRIVE	
MARCH 2003	
STANDARD DRAWING NO. E 610-DRIV-04	
DESIGNED BY L. J. VORHEES NO. 5100 DATE 3-03-03	CHECKED BY R. J. VORHEES NO. 5100 DATE 3-03-03
CHIEF HIGHWAY ENGINEER	

# NOTES:

1. The driveway detailed on this sheet shall be used when the mainline shoulder is paved and 6" or greater in width.
2. See Standard Drawing E 610-DRIV-07 for General Notes.
3. See Standard Drawing E 610-DRIV-07 for approach grades with paved shoulder.

existing driveway surface is asphalt or aggregate and


Existing Drive Surface  
Aggregate  
Asphalt

6" Compacted Agg. Surface, No. 73  
(M) on (P)

## LEGEND

- (M) Limits of HMA for approaches
- (P) Limits of compacted aggregate base
- (S) Equivalent to surface in place - see above


Width variable  
165 #3 grad HMA Surface Type A on  
275 #5 grad HMA Intermediate Type A on  
4-in. compacted aggregate base

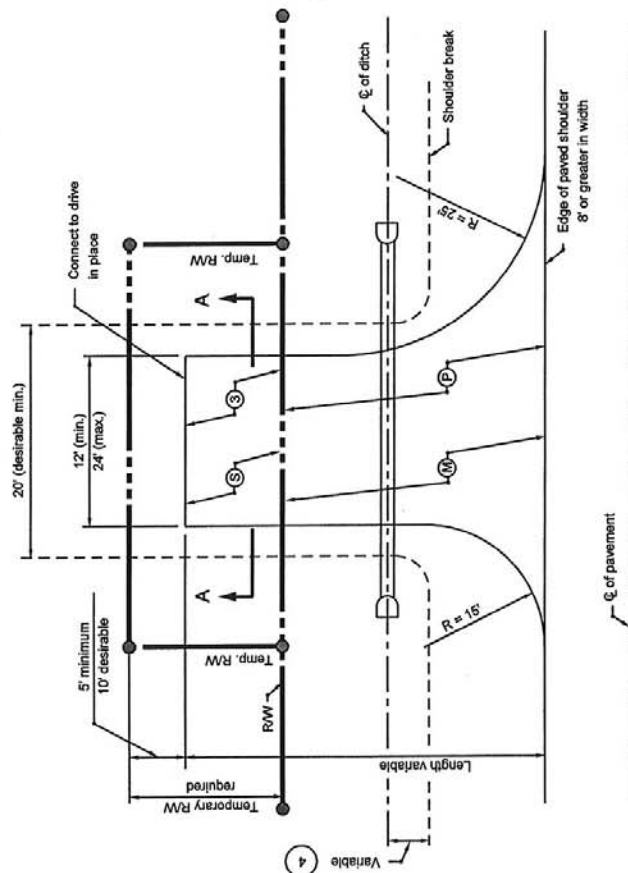

PLAN VIEW


## HMA FOR APPROACHES

TYPICAL SECTION

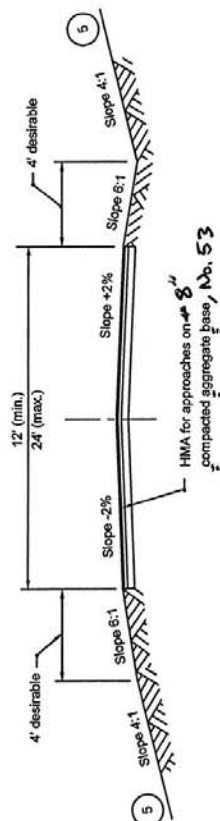

SECTION A-A

INDIANA DEPARTMENT OF TRANSPORTATION	
CLASS II DRIVE	
MARCH 2003	
STANDARD DRAWING NO. E 610-DRIV-05	
DESIGNER NO. 5150 DATE 3-03-03	CHECKED NO. 5150 DATE 3-03-03
DESIGNED NO. 5150 DATE 3-03-03	APPROVED NO. 5150 DATE 3-03-03
CHIEF HIGHWAY ENGINEER	

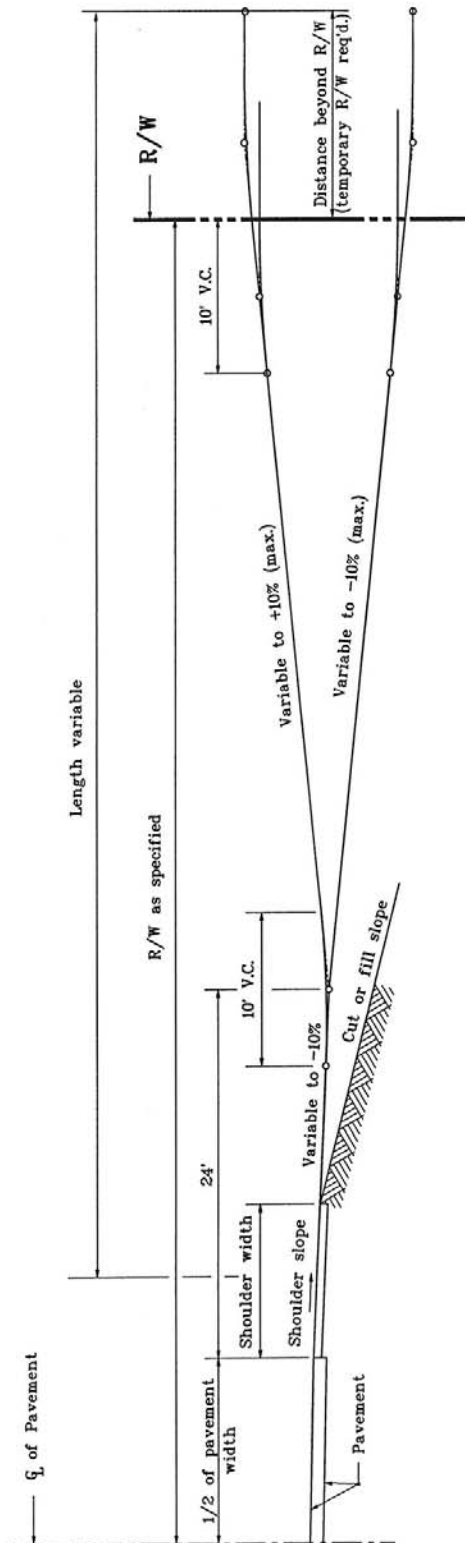

# APPROACH GRADE FOR CUT OR FILL TO BE USED WITH PAVED SHOULDER

## GENERAL NOTES :

1. These notes are for the drawings E 610-DRIV-04, -05, -06, -09, -10 and -11.
2. If a concrete approach is ~~required~~ <sup>required</sup> for a class II or class IV drive, the radii shall be constructed using ear construction type ~~as detailed~~ <sup>as detailed</sup> on Standard Drawing E 605-ERCN-~~02~~ <sup>01</sup>.
3. When the maximum approach grade of  $\pm 10\%$  does not meet the grade of the existing drive before the R/W line, the approach grade of  $\pm 10\%$  shall extend beyond the R/W to the point of intersection with the existing driveway grade. Construction beyond the R/W line shall be done in temporary R/W.
4. Driveway culverts which cannot be located outside the clear zone shall have appropriate end sections at both ends of the culvert.
5. Driveway embankment slope within the clear zone for a road functionally classified as follows shall be:
  - a.) 6:1 for an arterial or a high speed (over 40 mph design speed) collector.
  - b.) 4:1 for a local road or a low speed (40 mph or lower design speed) collector.

the driveway section shall be 6" recp for Approaches on 6" Dense Graded Subbase and

INDIANA DEPARTMENT OF TRANSPORTATION	
CLASS II, IV, & V DRIVES APPROACH GRADES	
MARCH 20-02	
STANDARD DRAWING NO. E 610-DRIV-07	
<div style="display: flex; justify-content: space-between;"> <div> <p>DESIGNED BY /s/ Richard K. Switzer 3-01-02</p> <p>CHECKED BY /s/ Richard K. Switzer 3-01-02</p> </div> <div> <p>DATE 3-01-02</p> </div> </div>	

# NOTES :


1. See Standard Drawing E 610-DRIV-01 for Section A-A. See Standard Drawing E 610-DRIV-02 for Section B-B. See Standard Drawing E 610-DRIV-03 for Section C-C.
2. For Class III drive, PCPP for Approaches ~~to~~ <sup>for</sup> driveways shall be placed over 6 in. of compacted aggregate for base, type ~~of~~ <sup>as shown</sup> No. 53.
3. See Standard Drawing E 610-DRIV-16 for ~~keyway~~ joint detail for longitudinal construction joint
4. See Standard Drawing E 610-DRIV-07 for General Notes.

5. See Standard Drawing E 610-DRIV-04 for appropriate aggregate and asphalt driveway sections


## LEGEND

- W = Width of sidewalk  
Wd = Driveway width  
X = Distance between back face of curb and sidewalk  
Y = Distance from front face of curb to  $E$  or R/W  
[Symbol] Curb ramp

6. For construction type B ~~as shown~~ <sup>as shown</sup> on Standard Drawing E 605-DRIV-02

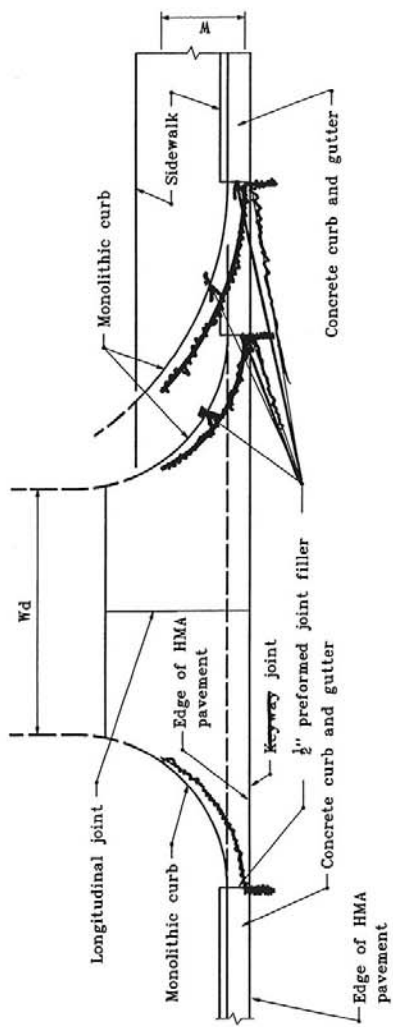

CONCRETE CURB & GUTTER CONNECTION FOR CLASS I & III DRIVES

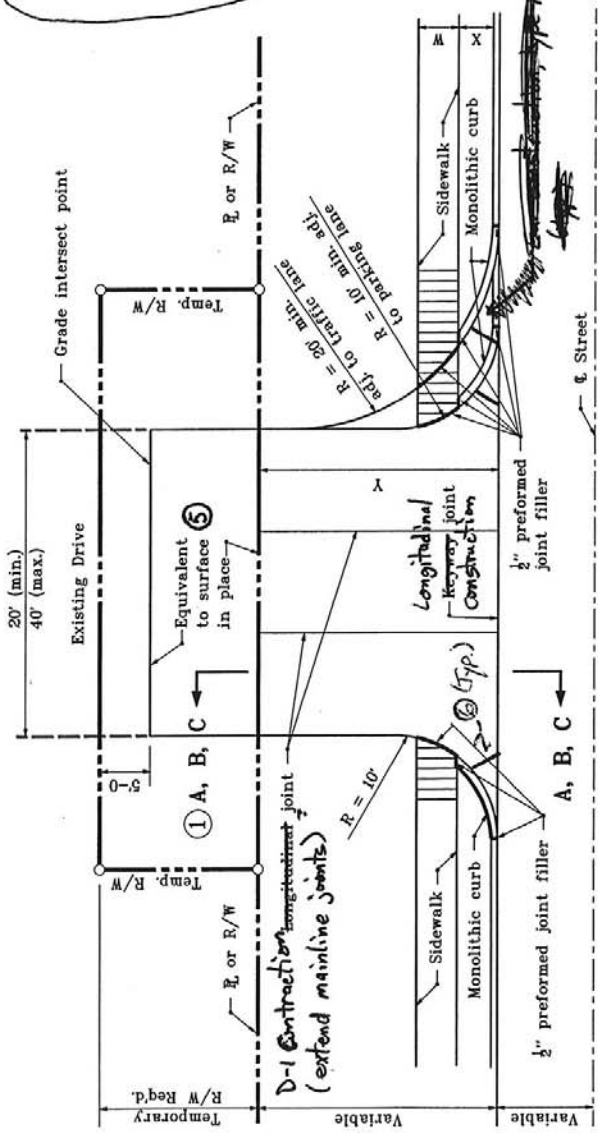

PLAN VIEW - CLASS III DRIVE

INDIANA DEPARTMENT OF TRANSPORTATION	
CLASS III DRIVE	
JANUARY 2000	
STANDARD DRAWING NO. E 610-DRIV-08	
<div style="display: flex; justify-content: space-between;"> <div> <p>DESIGNED BY: [Signature]</p> <p>CHECKED BY: [Signature]</p> <p>DATE: 1-02-00</p> </div> <div> <p>CHIEF ENGINEER: [Signature]</p> <p>DATE: 1-02-00</p> </div> </div>	

# NOTES:


- The driveway detailed on this sheet shall be used under the following conditions:  
- the mainline shoulder is paved and is less than 8 ft in width  
- the existing drive surface is asphalt or aggregate
- See Standard Drawing E 610-DRIV-07 for General Notes.
- See Standard Drawing E 610-DRIV-06 for Sections A-A and B-B.

Existing Drive Surface  
Aggregate  
Asphalt  
6" Compacted Agg. Surface, No. 73  
(M) on (P)


## LEGEND

- (M) Limits of HMA for approaches
- (P) Limits of compacted aggregate base
- (S) Equivalent to surface in place - see above

Width variable  
B  
165 #30 HMA Surface Type A on B  
165 #30 HMA Intermediate Type A on B

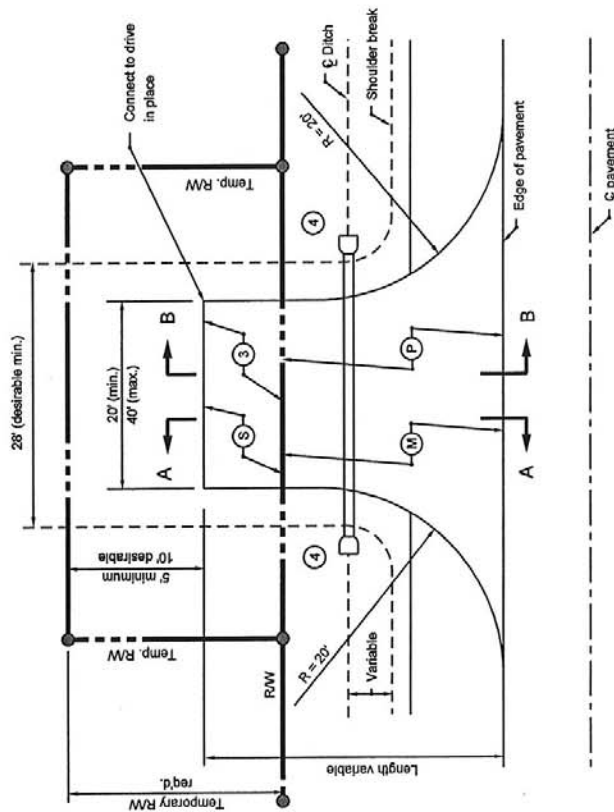

## PLAN VIEW COMMERCIAL

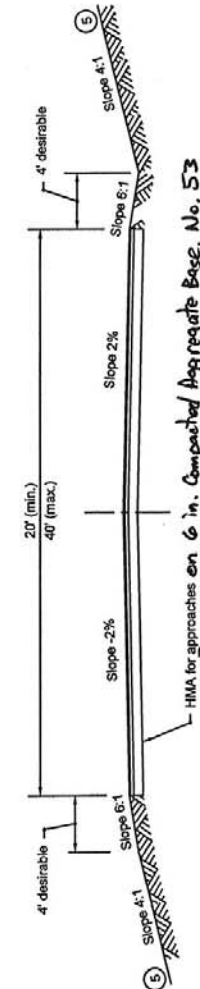

## CROSS SECTION


## HMA FOR APPROACHES TYPICAL SECTION

INDIANA DEPARTMENT OF TRANSPORTATION	
CLASS IV DRIVE	
MARCH 2003	STANDARD DRAWING NO. E 610-DRIV-08
DESIGN ENGINEER ROBERT L. VOTH DATE 3-03-03	CHECKED BY DATE 3-03-03



# NOTES:


1. The driveway detailed on this sheet shall be used where the mainline shoulder is paved and 8 in. or greater in width.
2. See Standard Drawing E 610-DRIV-07 for General Notes and approach grades.
3. See Standard Drawing E 610-DRIV-08 for HMA for approaches - Typical Section.

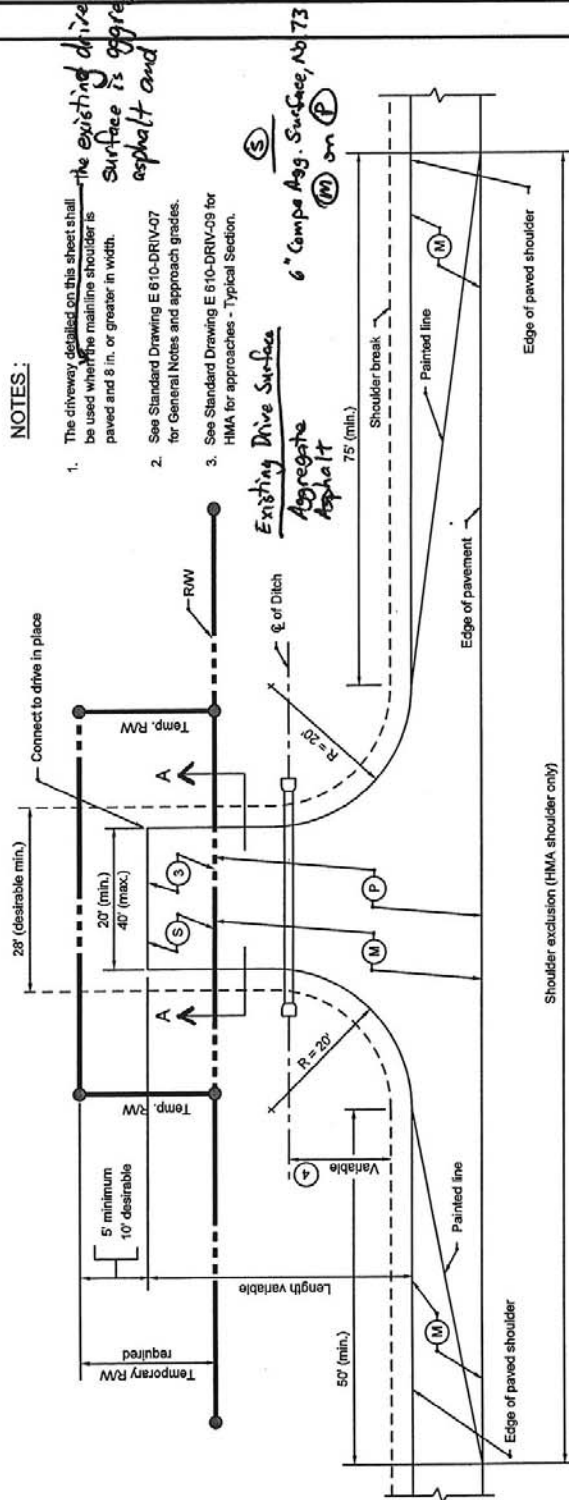


## LEGEND

- (M) Limits of HMA for approaches
- (P) Limits of compacted aggregate base
- (S) Equivalent to surface in place


## PLAN VIEW

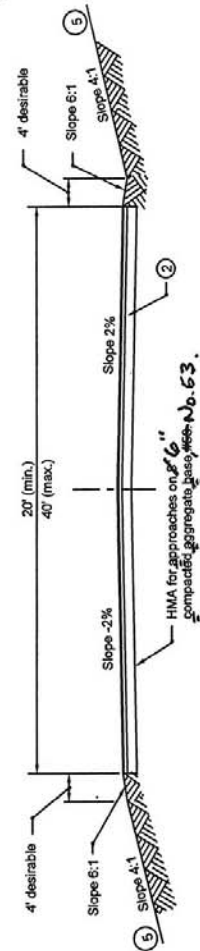


INDIANA DEPARTMENT OF TRANSPORTATION	
CLASS IV DRIVE	
MARCH 2003	
STANDARD DRAWING NO. E 610-DRIV-10	
DATE	DATE
3-03-03	3-03-03
CHEF HIGHWAY ENGINEER	CHEF HIGHWAY ENGINEER

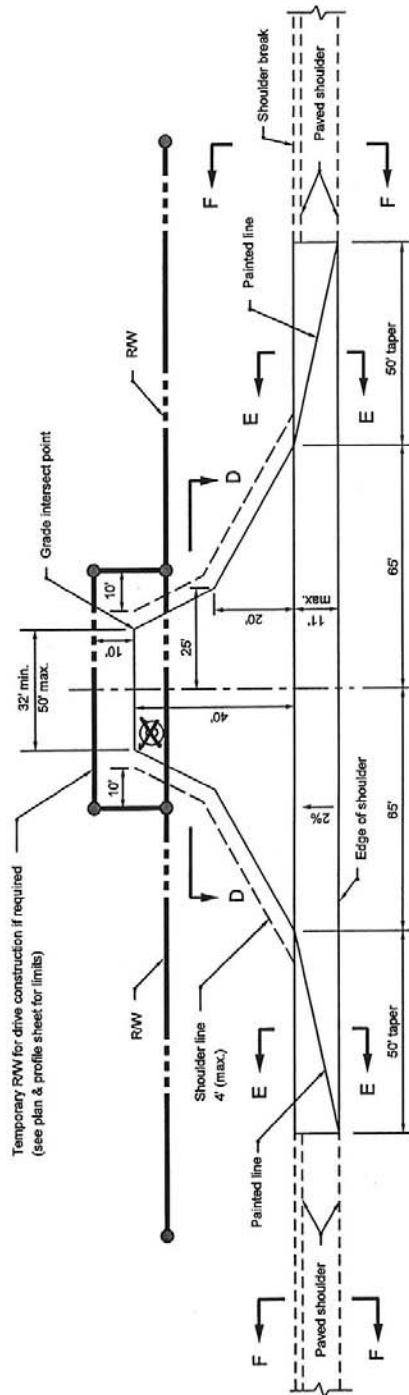

CLASS VI DRIVE - PLAN  
COMMERCIAL

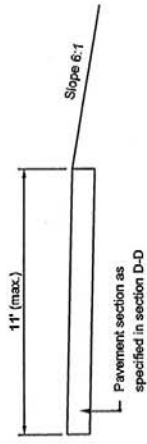


SECTION E-E

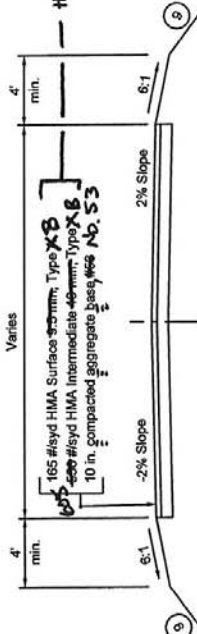

SECTION D-D

- NOTES:**
1. The Class VI Drive is designed to accommodate a WB-20 (IDV) design vehicle with a 45 ft turning radius. This drive shall be specified at truck stops and entrances to heavy industrial property.
  2. See Standard Drawing E 610-DRIV-13 for profile grades.
  3. See Standard Drawing E 610-DRIV-14 for General Notes and Legend.

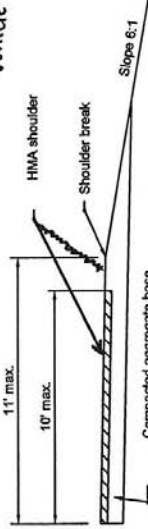

SECTION F-F

INDIANA DEPARTMENT OF TRANSPORTATION	
CLASS VI DRIVE PLAN AND SECTIONS	
MARCH 2003	
STANDARD DRAWING NO. E 610-DRIV-12	
	DATE 3-03-03 3-03-03 DATE 3-03-03

# GENERAL NOTES :

1. These notes are for Standard <sup>Drawings</sup> ~~Drawing~~ E 610-DRIV-12, -13, -15, -16.
2. The class VI and VII drives are designed to accomodate a WB-65 (DV) design vehicle with a 45 ft turning radius.
- ⑦ The maximum algebraic difference in grades shall not exceed 8% for <sup>crested</sup> ~~sagged~~ grade nor 12% for ~~sagged~~ grades.
- ⑧ The minimum driveway pavement section has been designed for 200 trucks per day. If the truck traffic count is greater than 200 per day, the required pavement section shall be as shown elsewhere on the plans.
- ⑨ Driveway embankment slopes within the clear zone for a road functionally classified as follows shall be :  
6 : 1 for an arterial or a high speed (over 40 mph design speed) collector.  
4 : 1 for a local road or a low speed (40 mph or lower design speed) collector.
- ⑩ Driveway culverts which cannot be located outside the clear zone shall have appropriate end sections at both ends.
- ⑪ Hc - earth cover over culvert or pipe shall be 1 ft or greater.
- ⑫ Curb ramp type C, as shown on Standard Drawing E 604-SWCR-09, shall be used when sidewalk is adjacent to curb.
- ⑬ When X is equal to or greater than 2 ft but less than 5 ft, curb ramp type H as shown on Standard Drawing E 604-SWCR-09 shall be used.
- ⑭ When X is equal to or greater than 5 ft, no curb ramp is required.

## LEGEND

③ <sup>D-1</sup> ~~Contraction~~ <sup>Longitudinal</sup> ~~transverse~~ joint  
④ <sup>Longitudinal</sup> ~~transverse~~ construction  
⑤ 1/2 in. preformed joint filler


⑥ Monolithic curb  
⑦ Concrete sidewalk  
⑧ ~~For type and thickness equivalent to surface in place, see plans~~

⑨ Concrete curb ramp

X = Distance between face of curb and sidewalk

W = Width of sidewalk

<sup>PCC</sup> ~~Cement concrete pavement for Driveways~~

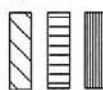

<sup>Approaches</sup>


Curb ramp  
Curb ramp view

INDIANA DEPARTMENT OF TRANSPORTATION

CLASS VI AND VII DRIVES  
GENERAL NOTES AND LEGEND

MARCH 2002

STANDARD DRAWING NO. E 610-DRIV-14

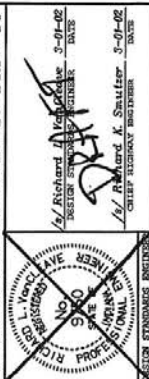

DATE 3-01-02  
CHIEF ENGINEER




4. See Standard Drawing E 610-DRIV-14 for General Notes and Legend.


STANDARD DRAWING NO. E 610-DRIV-15

DATE: 1-03-00  
DESIGN: 1-03-00  
NAME: Anthony L. ...


✓ Firooz Zandi 1-03-00

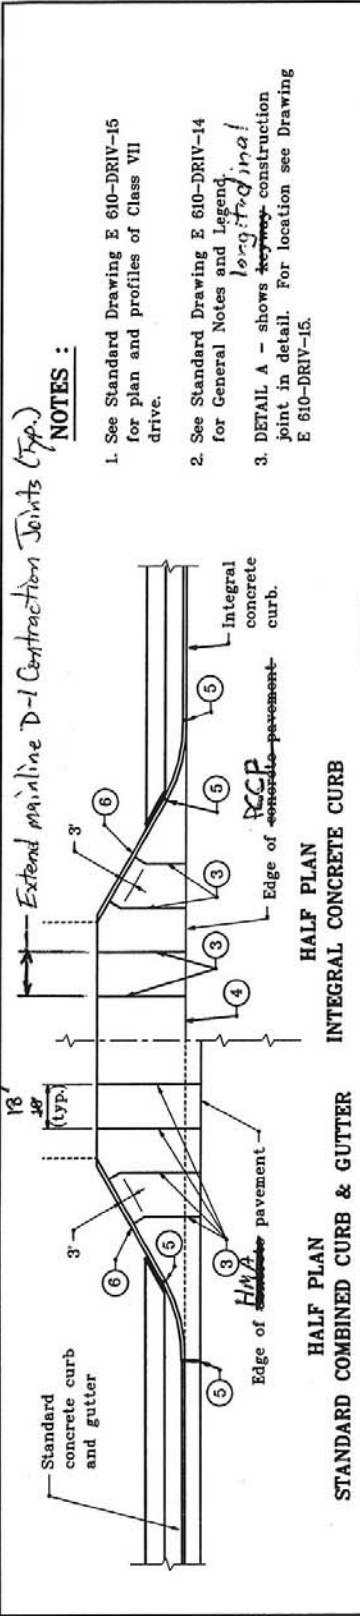


**JOINT PLACEMENT DETAIL**

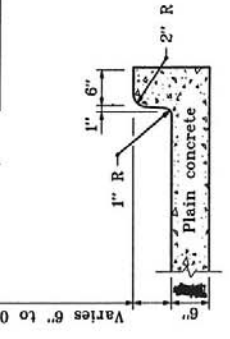

**MONOLITHIC CURB**

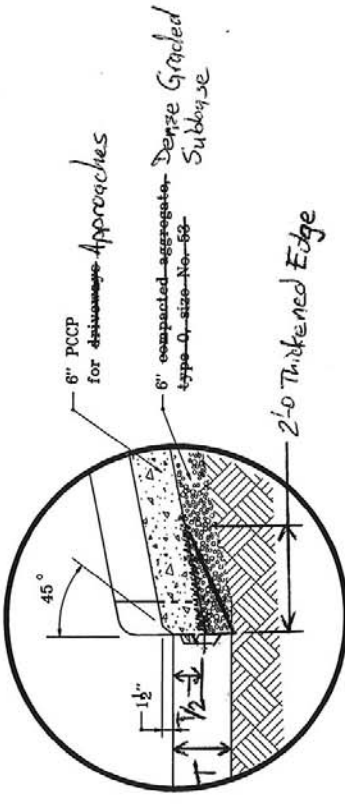


**DETAIL A**

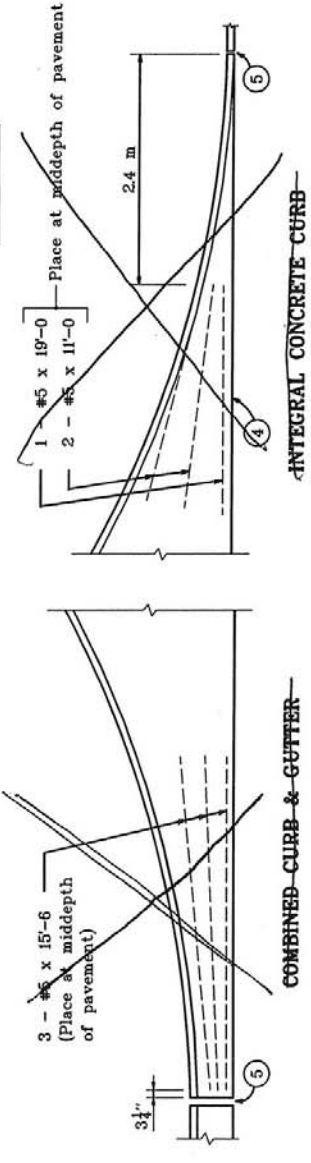



**NOTES :**

1. See Standard Drawing E 610-DRIV-15 for plan and profiles of Class VII drive.
2. See Standard Drawing E 610-DRIV-14 for General Notes and Legend.
3. DETAIL A - shows ~~keyway~~ *longitudinal* construction joint in detail. For location see Drawing E 610-DRIV-15.



INDIANA DEPARTMENT OF TRANSPORTATION	
CLASS VII DRIVE	
JOINT PLACEMENT AND CORNERS	
JANUARY 2000	
STANDARD DRAWING NO. E 610-DRIV-16	
<div style="display: flex; justify-content: space-between;"> <div> <p>DESIGNED BY: <i>[Signature]</i></p> <p>CHECKED BY: <i>[Signature]</i></p> <p>DATE: <i>[Signature]</i></p> </div> <div> <p>NO. 1085</p> <p>DATE: <i>[Signature]</i></p> <p>PROF. <i>[Signature]</i></p> </div> </div>	

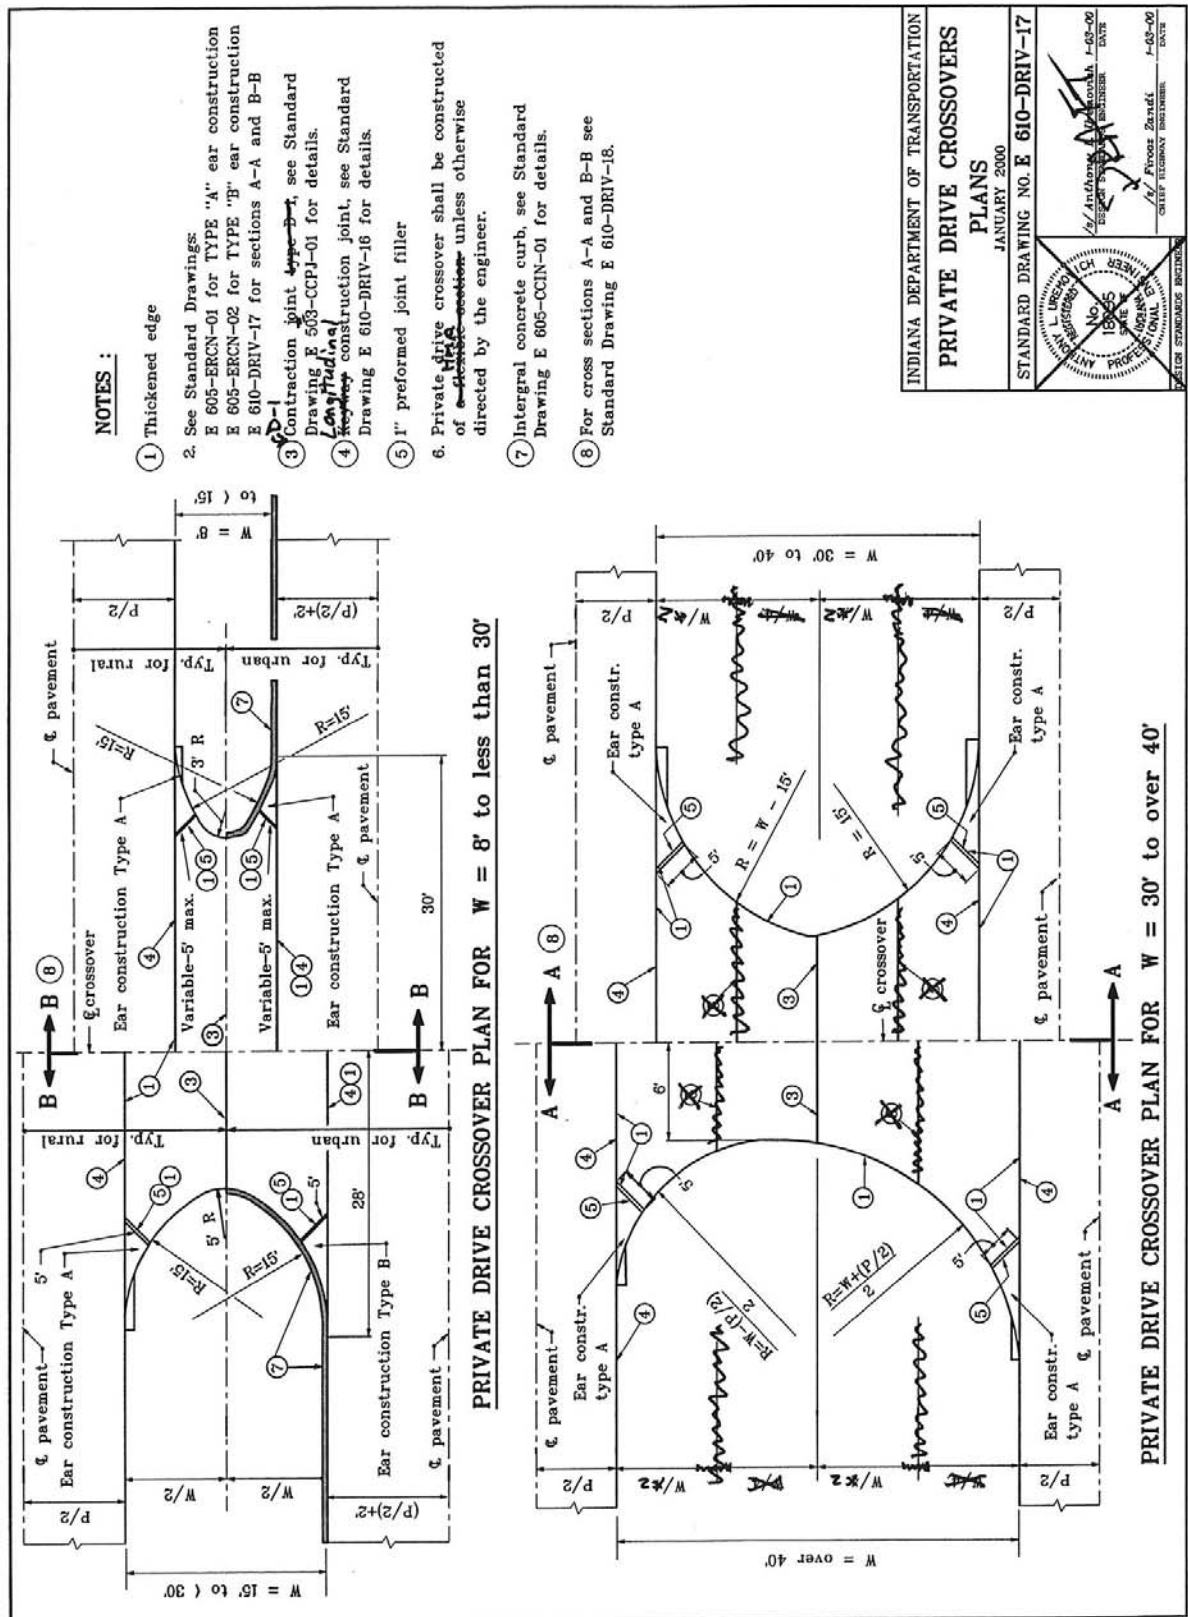

INDIANA DEPARTMENT OF TRANSPORTATION	
PRIVATE DRIVE CROSSOVERS	
PLANS	
STANDARD DRAWING NO. E 610-DRIV-17	
JANUARY 2000	
11/ Anthony J. [Signature] 1-03-00 ENGINEER DATE	
11/ Feroze Zaidi 1-03-00 CHIEF ENGINEER DATE	

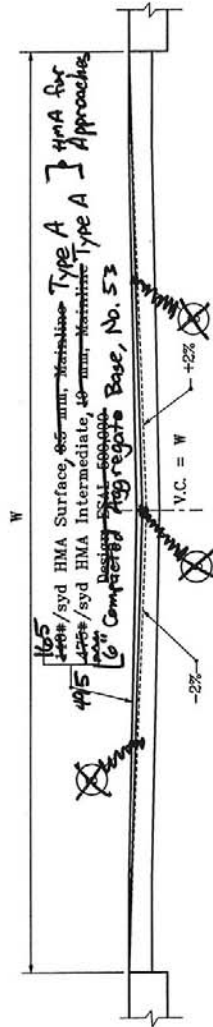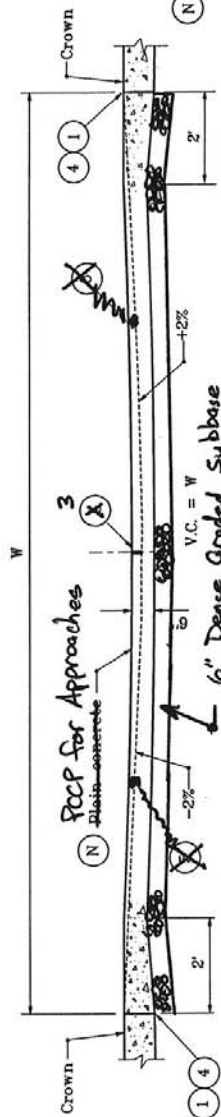

SECTION A-A  
TO BE USED WITH CROWN PAVEMENTS.

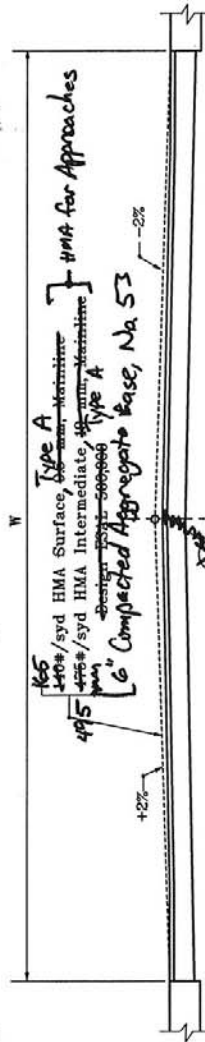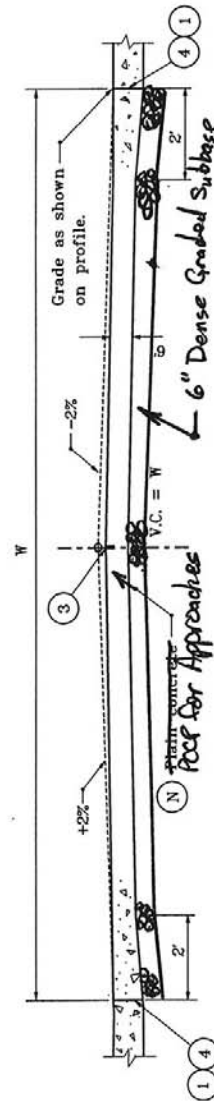


SECTION B-B  
TO BE USED WITH 3 in. TILTED PAVEMENTS


# NOTES :

- (N) Private drive crossover shall be constructed of a flexible pavement unless otherwise directed by the Engineer.
- (1) Thickened edge to the mainline thickness varies from 6" to 12" for ~~thin concrete crossovers~~ **PCP for Approaches**
- (2) For location of cross sections see Standard Drawing E 610-DRIV-17.
- (3) Contraction joint type D-1, see Standard Drawing E 501-CCPJ-08 for details.
- (4) ~~Keyway~~ **Longitudinal** construction joint, see Standard Drawing E 610-DRIV-16 for details.
- (5) 1" preformed joint filler

INDIANA DEPARTMENT OF TRANSPORTATION	
PRIVATE DRIVE CROSSOVERS	
CROSS SECTIONS	
JANUARY 2000	
STANDARD DRAWING NO. E 610-DRIV-18	
	1/1 Jeffrey A. Zetzel DESIGN STANDARD ENGINEER DATE 1-03-00 1/1 David Zetzel CHECK RECORDS ENGINEER DATE 1-03-00

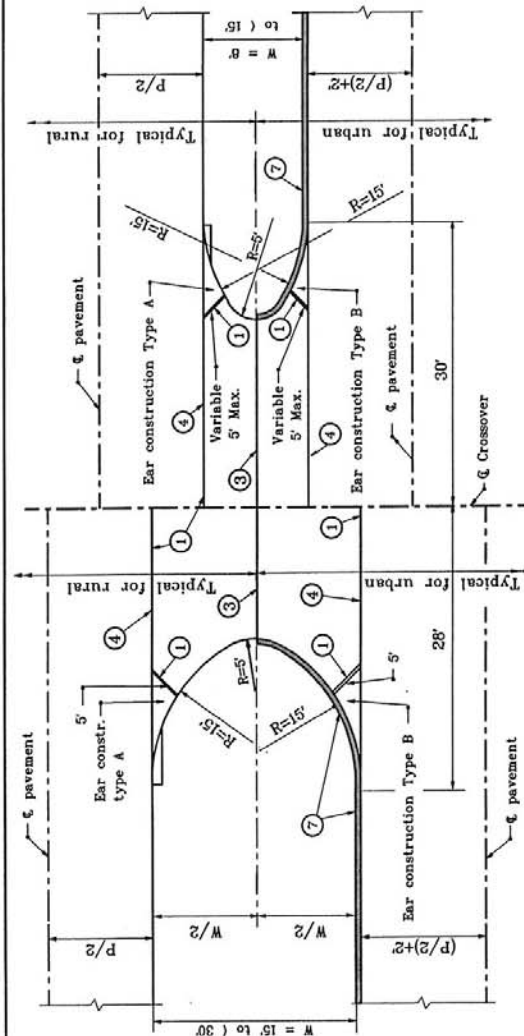

COMMERCIAL DRIVE CROSSOVER PLAN FOR W = 8' to less than 30'

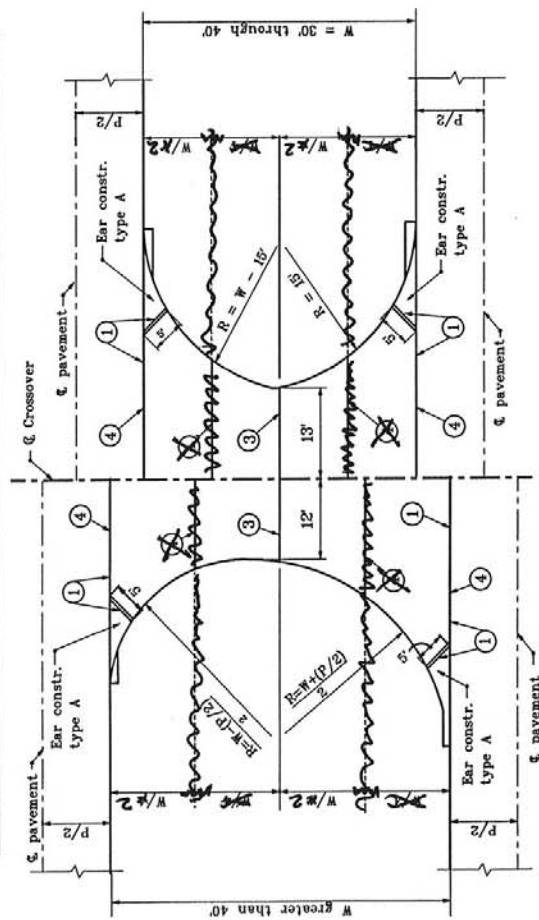

COMMERCIAL DRIVE CROSSOVER PLAN FOR W = 30' to over 40'

NOTES :

- 1 Thickened edge
- 2 See Standard Drawings :  
E 606-ERCN-01 for TYPE "A" ear construction  
E 606-ERCN-02 for TYPE "B" ear construction
- 3 Contraction joint type B - see Standard Drawing E 506-CCPI-01 for details.
- 4 Longitudinal joint - see Standard Drawing E 610-DRIV-16 for details.
- 5 HMA
- 6 Grade and cross section for commercial drive crossover shall be the same as for private drive crossover, except that HMA Type B mixtures and used and shall be 100% /syd. For HMA and Rec crossroads.
- 7 Integral concrete curb, see Standard Drawing E 606-CCIN-01 for details.
- 8 Commercial drive crossover shall be constructed of HMA section unless otherwise directed by the Engineer.

INDIANA DEPARTMENT OF TRANSPORTATION	
COMMERCIAL DRIVE CROSSOVERS	
PLANS	
JANUARY 2000	
STANDARD DRAWING NO. E 610-DRIV-19	
DESIGN ENGINEER	DATE
CHECKED BY	DATE



Item No. 45-16  
Mr. Miller  
Date: 2/19/04

REVISION TO STANDARD DRAWINGS

---

610-PRAP-02, Public Road Approach Type A  
610-PRAP-03, Public Road Approach Type B  
610-PRAP-06, Public Road Approach Type C  
610-PRAP-10, Public Road Approach Type D  
610-PRAP-13, Public Road Approach, HMA Mainline Pavement  
610-PRAP-14, Public Road Approach, PCCP or HMA Mainline Pavement

---

Other sections containing specific cross references:	General Instructions to Field Employees Update Required? Y___ N___ By - Addition or Revision Frequency Manual Update Required? Y___ N___ By - Addition or Revision
None	
Recurring Special Provisions potentially affected:	Standard Sheets potentially affected:
None	See Above
Motion: Mr.	Action: Passed as submitted; revised
Second: Mr.	Effective - _____ Letting
Ayes:	_____ Supplementals
Nays:	Withdrawn. Resubmit? _____
	Received FHWA Approval? _____